


DEFENSE PLANT CORPORATION PROPERTIES

RECONSTRUCTION FINANCE CORPORATION

PACIFIC MUTUAL BUILDING
Los Angeles 14, Calif.

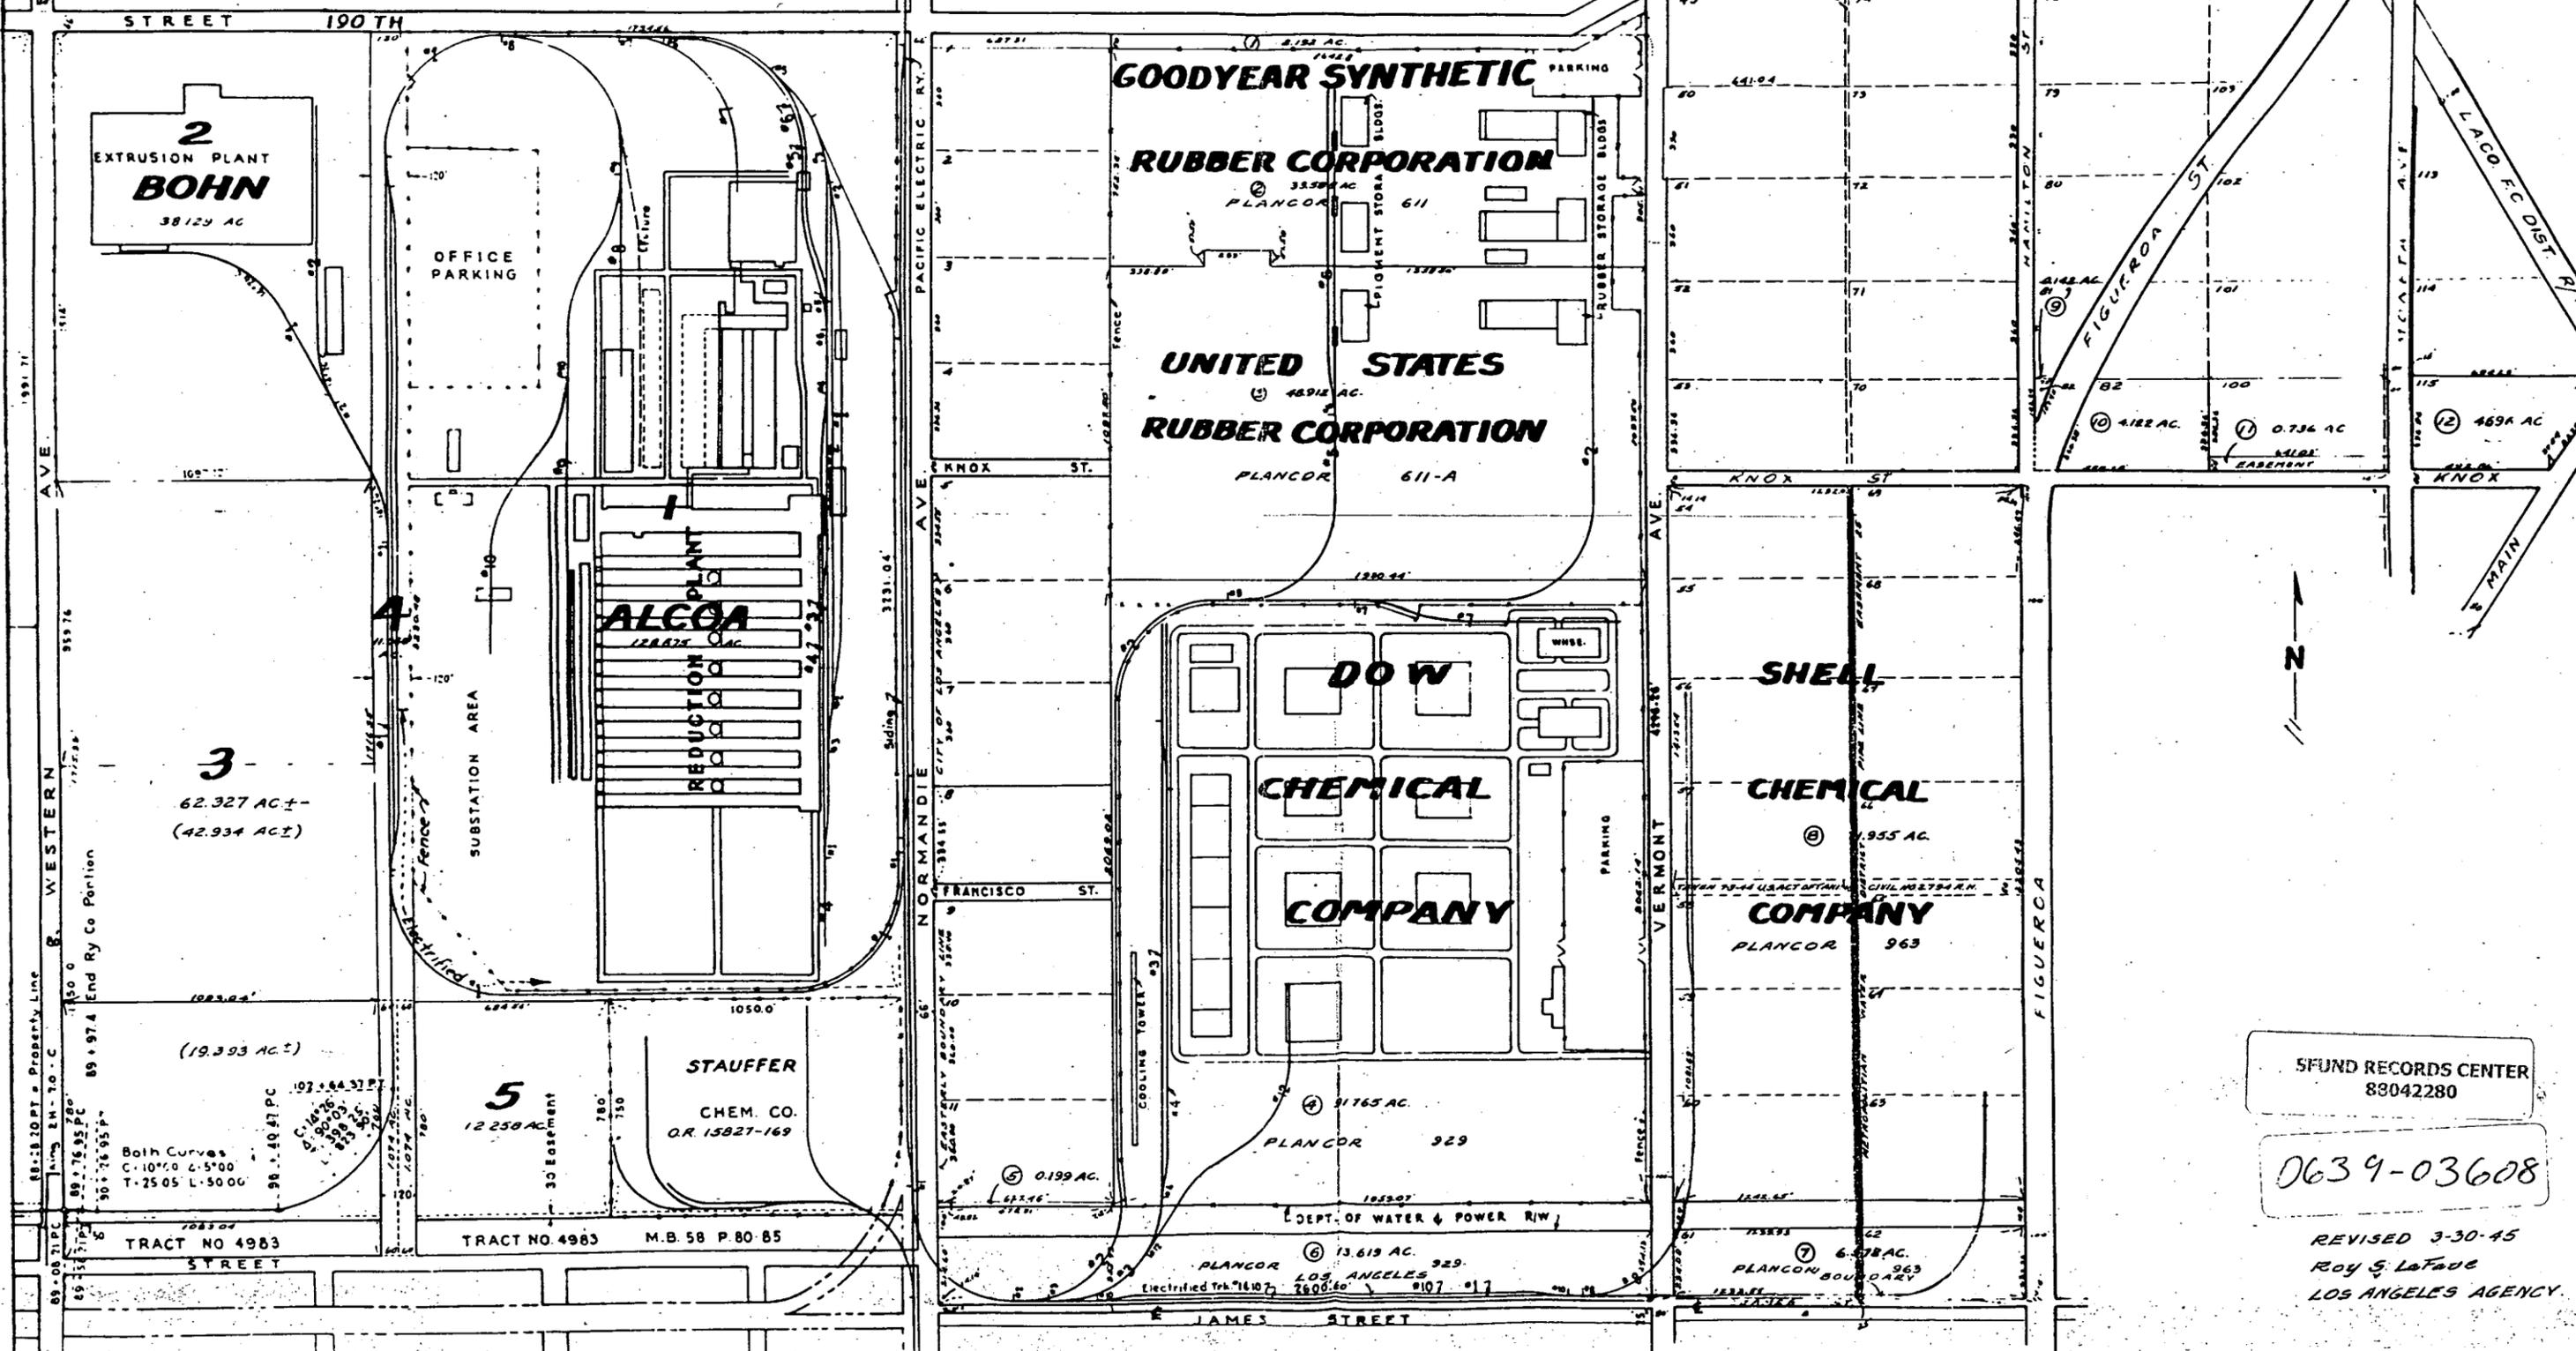

SFUND RECORDS CENTER
83042280


0639-03608

REVISED 3-30-45
Roy S. LaFare
LOS ANGELES AGENCY

DEFENSE PLANT CORPORATION PROPERTIES

RECONSTRUCTION FINANCE CORPORATION

PACIFIC MUTUAL BUILDING
Los Angeles 14, Calif.

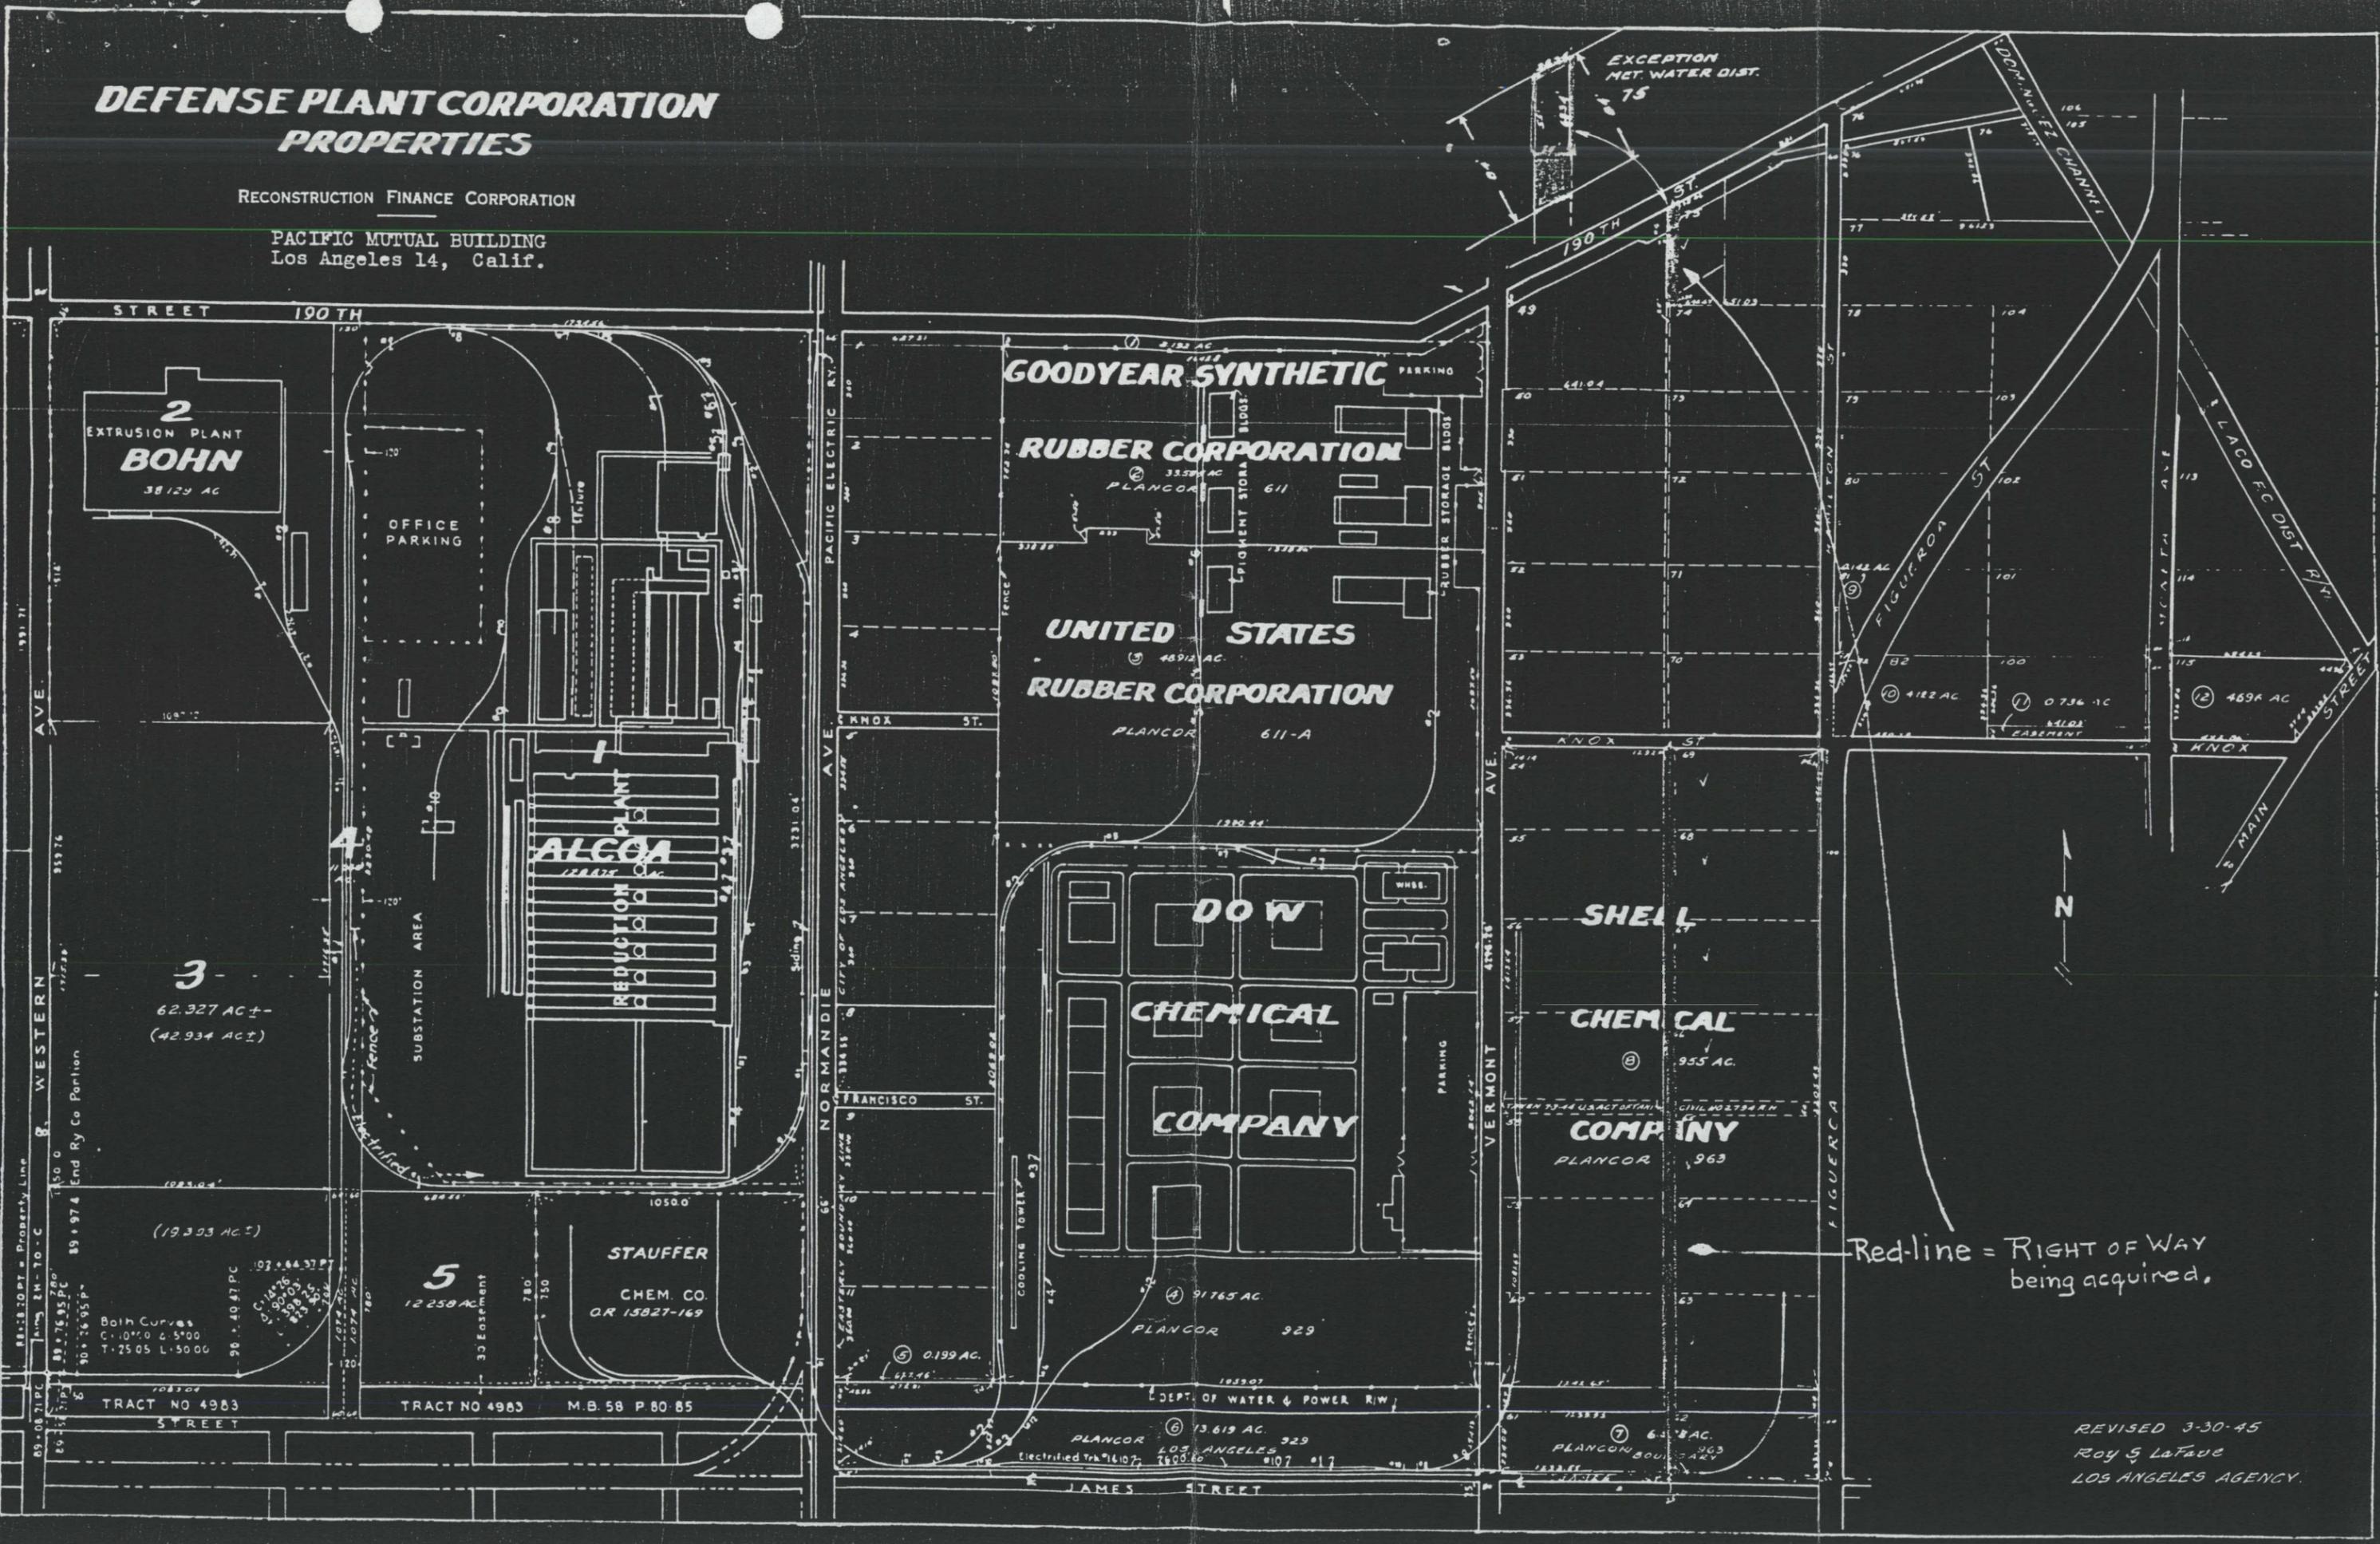

Red-line = RIGHT OF WAY
being acquired.

REVISED 3-30-45
Roy & LaFare
LOS ANGELES AGENCY.